

2020-04-21

**REQUEST FOR TENDER  
AFRICA PAVILION – WASHROOM UPGRADES  
RFT No.: TZC T 26-2020-03**

**ADDENDUM 6**

This addendum shall be incorporated into, and form part of RFT No.: TZC T 26-2020-03 and take precedence over all requirements of the previously issued bid documents including plans. This addendum must be signed by the bidder (signing officer) in the appropriate space and must be attached to the form for submission by the bidder. This addendum consists of ONE (1) page(s) and the documents listed below.

**1. DELETE DRAWINGS:**

SHEET NUMBER	SHEET NAME	ISSUE DATE
A203	REFLECTED CEILING PLAN	2020-04-14

**REPLACE WITH DRAWINGS:**

SHEET NUMBER	SHEET NAME	ISSUE DATE
A203	REFLECTED CEILING PLAN	2020-04-21

**2. QUESTION:**

Who will supply Translucent Plexiglass Acrylic Leaves Sheet? If supply by GC, Can you please provide specification for those leaves sheet?

**RESPONSE:**

The GC is responsible for the supply and install of these custom translucent plexiglass coloured sheets, which are cut to the leaf profiles as illustrated. Please reference the notes on the drawings.

Receipt of the addendum shall be acknowledged as part of your submission.

The Board of Management of the Toronto Zoo reserves the right to reject any or all quotations or to accept any quotation, should it deem such action to be in its interests.

If you have any queries regarding this matter, please contact Mr. Peter Vasilopoulos, Supervisor, Purchasing & Supply, at 416-392-5916.

Yours truly,

Peter Vasilopoulos  
Supervisor, Purchasing & Supply

I/we hereby acknowledge receipt of this addendum and make allowance in my bid.

---

Signed (Must be Signing Officer of Firm)

---

Name of Firm

---

Date

DO NOT SCALE OFF DRAWINGS. CONTRACTOR TO SITE VERIFY ALL DIMENSIONS AND REPORT ANY DISCREPANCIES TO ARCHITECT. DRAWINGS ARE THE PROPERTY OF THE ARCHITECT AND ARE NOT TO BE REPRODUCED AND DISTRIBUTED WITHOUT WRITTEN PERMISSION FROM ARCHITECT. DRAWINGS ARE NOT TO BE USED FOR ANY PURPOSE OTHER THAN THE LATEST ISSUE SHOWN BELOW.

NO.	DESCRIPTION	DATE
01	50% REVIEW	19/09/24
02	TENDER REVIEW	19/10/04
03	TENDER	19/10/29
04	TENDER	20/03/13
05	ADDENDUM #01	20/04/02
06	ADDENDUM #02	20/04/08
07	ADDENDUM #03	20/04/14
08	CLARIFICATION	20/04/21



TORONTO ZOO  
 361A OLD FINCH AVE  
 TORONTO, ONTARIO, M1B 5K7  
 WASHROOM UPGRADES - AFRICAN PAV.

**REFLECTED CEILING PLAN**

Project number	2019-06
Date	2019-10-04
Drawn by	M FAULDS
Checked by	J HORVATH

**A203**

Scale As indicated

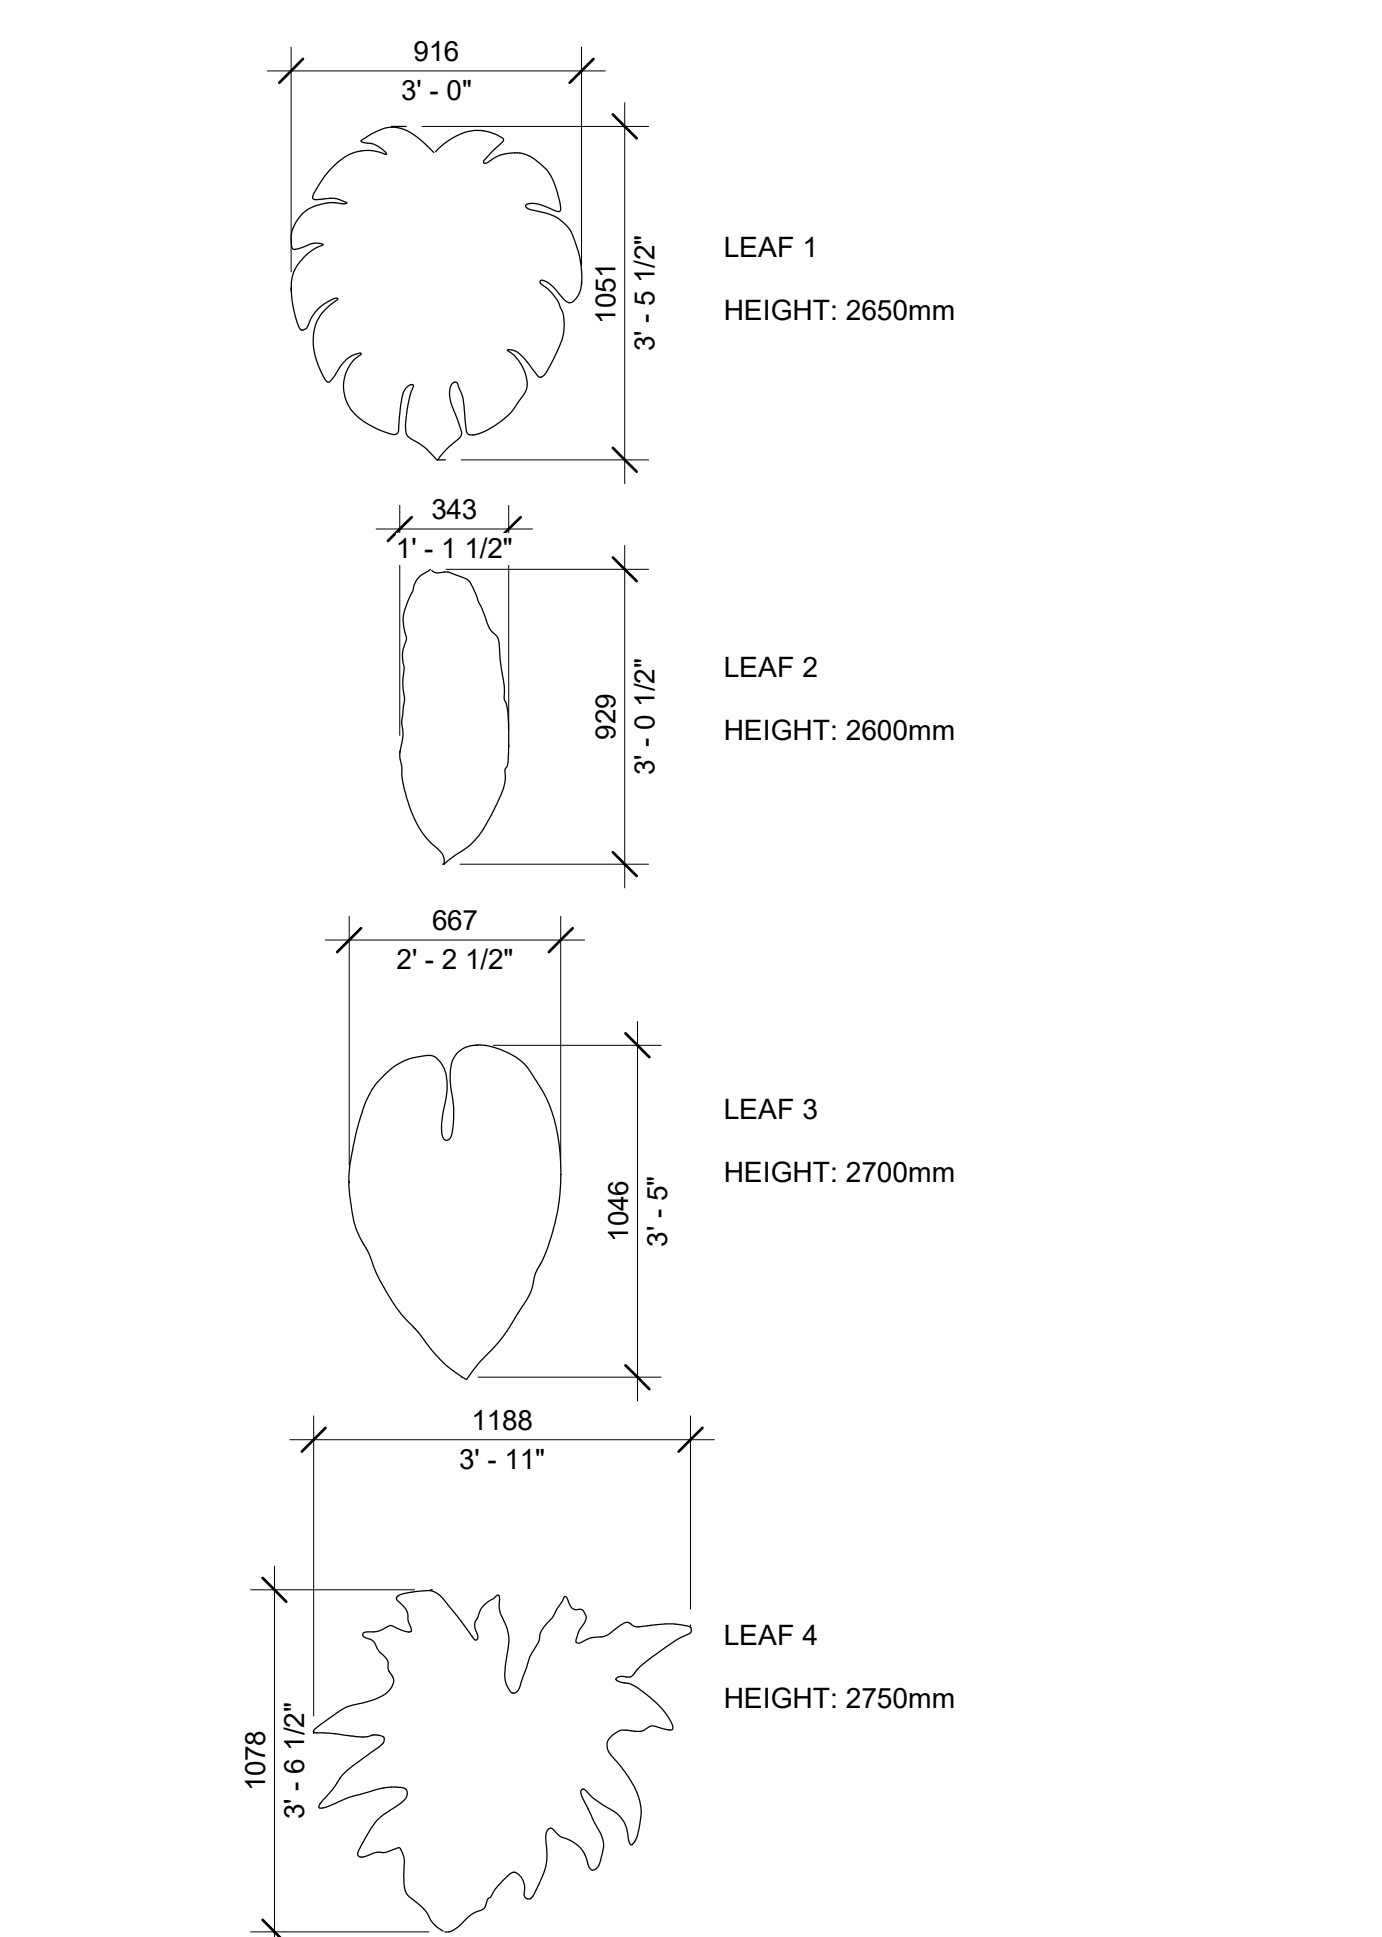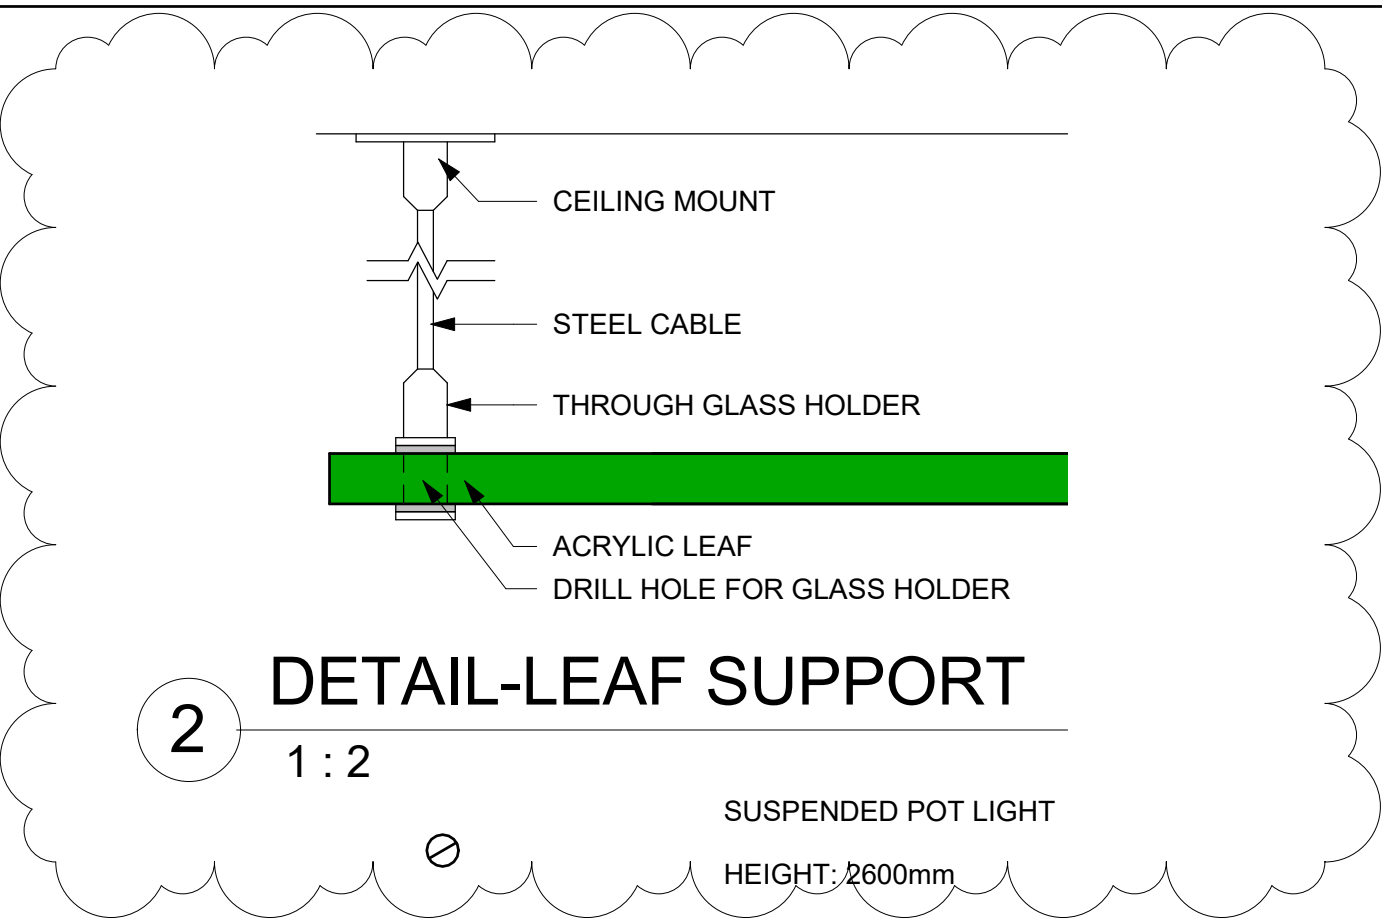

- NOTE:
- LEAVES ARE TO BE MADE OF TRANSLUCENT PLEXIGLASS COLOURED ACRYLIC SHEETS THAT ARE CUT TO THE LEAF PROFILES AS ILLUSTRATED. LEAF TEMPLATE CAN BE PROVIDED AT CONTRACTOR'S REQUEST OR A SIMILAR PROFILE CAN BE SUBMITTED FOR CONSULTANTS REVIEW
  - TRANSPARENT PLEXIGLASS SHEETS TO BE A MINIMUM OF 1/4" (6mm) THICK.
  - COLOUR OF LEAVES TO BE A VARIETY OF GREEN FROM LIGHT GREEN TO DARK GREEN. THREE GREEN COLOURS ARE TO BE SELECTED AND ARE TO BE CUSTOM COLOURED.
  - LEAVES TO BE SUSPENDED FROM CONCRETE CEILING SLAB UTILIZING CABLE SYSTEM SUCH AS THE ORL CABLE DISPLAY SYSTEM OR APPROVED EQUIVALENT
  - HEIGHT OF LEAVES TO RANGE. AS THERE ARE FOUR LEAF PROFILES, EACH PROFILE SHALL BE INSTALLED AT A DIFFERENT HEIGHT RANGING IN 50mm +/- INTERVALS.
  - EXACT PLACEMENT OF LEAVES TO BE REVIEW AND APPROVED WITH THE CONSULTANT PRIOR TO FINAL INSTALL. ALLOW FOR ADJUSTMENTS DUE TO ELECTRICAL AND MECHANICAL PLACEMENTS.
  - ALL CEILINGS, MECHANICAL AND ELECTRICAL CEILING COMPONENTS (I.E. DUCTWORK, CONDUITS, ETC.) ARE TO BE PAINTED THROUGHOUT AND UTILIZE PAINT SPECIFIED IN FINISH SCHEDULE ON A002.
  - COORDINATE INSTALL OF ALL LEAVES WITH CONSULTANT.
  - ENSURE SMOKE DETECTORS ARE NOT COVERED BY LEAVES
  - REFER TO ELECTRICAL DRAWINGS FOR FLOOD LIGHT LOCATIONS. FLOOD LIGHTS TO BE INSTALLED CLOSE TO U/S OF CEILING SLAB.
  - OCCUPANCY SENSORS AND SMOKE DETECTORS ARE TO BE INSTALL CLOSE TO U/S OF CEILING SLAB
  - PULL STATIONS AND LIGHT SWITCHES ARE TO BE INSTALLED 1100mm AFFL, IF PRESENT

