

2022-07-12

**REQUEST FOR TENDERS
LIBRARY REFURBISHMENT
RFQ 34 (2022-06)
ADDENDUM #2**

This addendum shall be incorporated into, and form part of RFQ 34 (2022-06) and take precedence over all requirements of the previously issued bid documents including plans. This addendum must be signed by the bidder (signing officer) in the appropriate space and must be attached to the Form for submission by the bidder. This Addendum consists of three (3) pages and the attached documents.

1. **QUESTION:** If we are providing existing thermostats we will need existing thermostat model.

RESPONSE: Standard thermostat, Honeywell, Pro 8000 model.

2. **QUESTION:** Is Communication cabling is part of this tender? if so, please provide IT closet location where the cable to terminate.

RESPONSE: Please refer to Addendum #1, plan A3.03. IT closet shares the space with Electrical closet.

3. **QUESTION:** For new receptacles If new circuit required, please confirm location of existing electrical panel and availability of breaker space.

RESPONSE: Yes, space is available in the electrical closet.

4. **QUESTION:** There are additional items I need to refer to sub-trades. Can an extension to next week be granted for the tender closing?

RESPONSE: Yes. See question 8 below in this Addendum #2.

5. **QUESTION:** What is the existing deck height, if the steel studs for the walls have to go to the underside of deck?

RESPONSE: Please refer to the revised plan A3.01. There is 43" from U/S of ceiling to U/S of deck.

6. **QUESTION:** What kind of flooring base will be used? Carpet or vinyl?

RESPONSE: Please refer to plan A3.01.

7. **DELETE DRAWINGS:**

A3.01 R1 – Proposed Layout

REPLACE WITH:

A3.01 R2 – Proposed Layout

8. Closing Date

Delete Original Closing date - **Thursday, 2022-07-14, 1200 hours (noon, local time)**

Revised Closing Date - **Friday, 2022-07-22, 1200 hours (noon, local time)**

9. 3.1 Scope of Work - Completion date

DELETE: Work is to be completed by **Thursday, 2022-09-15.**

REPLACE: Work is to be completed by **Friday, 2022-10-14.**

Receipt of the Addendum shall be acknowledged as part of your submission.

The Board of Management of the Toronto Zoo reserves the right to reject any or all Tenders or to accept any quotation, should it deem such action to be in its interests.

If you have any queries regarding this matter, please contact Mr. Peter Vasilopoulos, Supervisor, Purchasing & Supply, at 416-392-5916 or by email pvasilopoulos@torontozoo.ca.

Yours truly,

Peter Vasilopoulos
Supervisor, Purchasing & Supply

I/we hereby acknowledge receipt of this addendum and make allowance in my bid.

Signed (Must be Signing Officer of Firm)

Name of Firm

Date:

END OF ADDENDUM 2

NO.	DESCRIPTION	DATE
1	ADDENDUM 1	2022-07-07
2	ADDENDUM 2	2022-07-12

NO.	REVISIONS	DATE
-----	-----------	------



LIBRARY
RE-CONFIGURATION


REVIEWED BY
MANAGER: BEN KNOOP
DATE:
CURATOR:
DATE:
APPROVED BY
COO:
DATE:

PROPOSED
LAYOUT

PROJECT #: 22OP04-A
DRAWN BY: MR
CHECKED BY:
DATE: 2022-06-16
SCALE: 1/4" = 1'-0"

DRAWING #:

A3.01

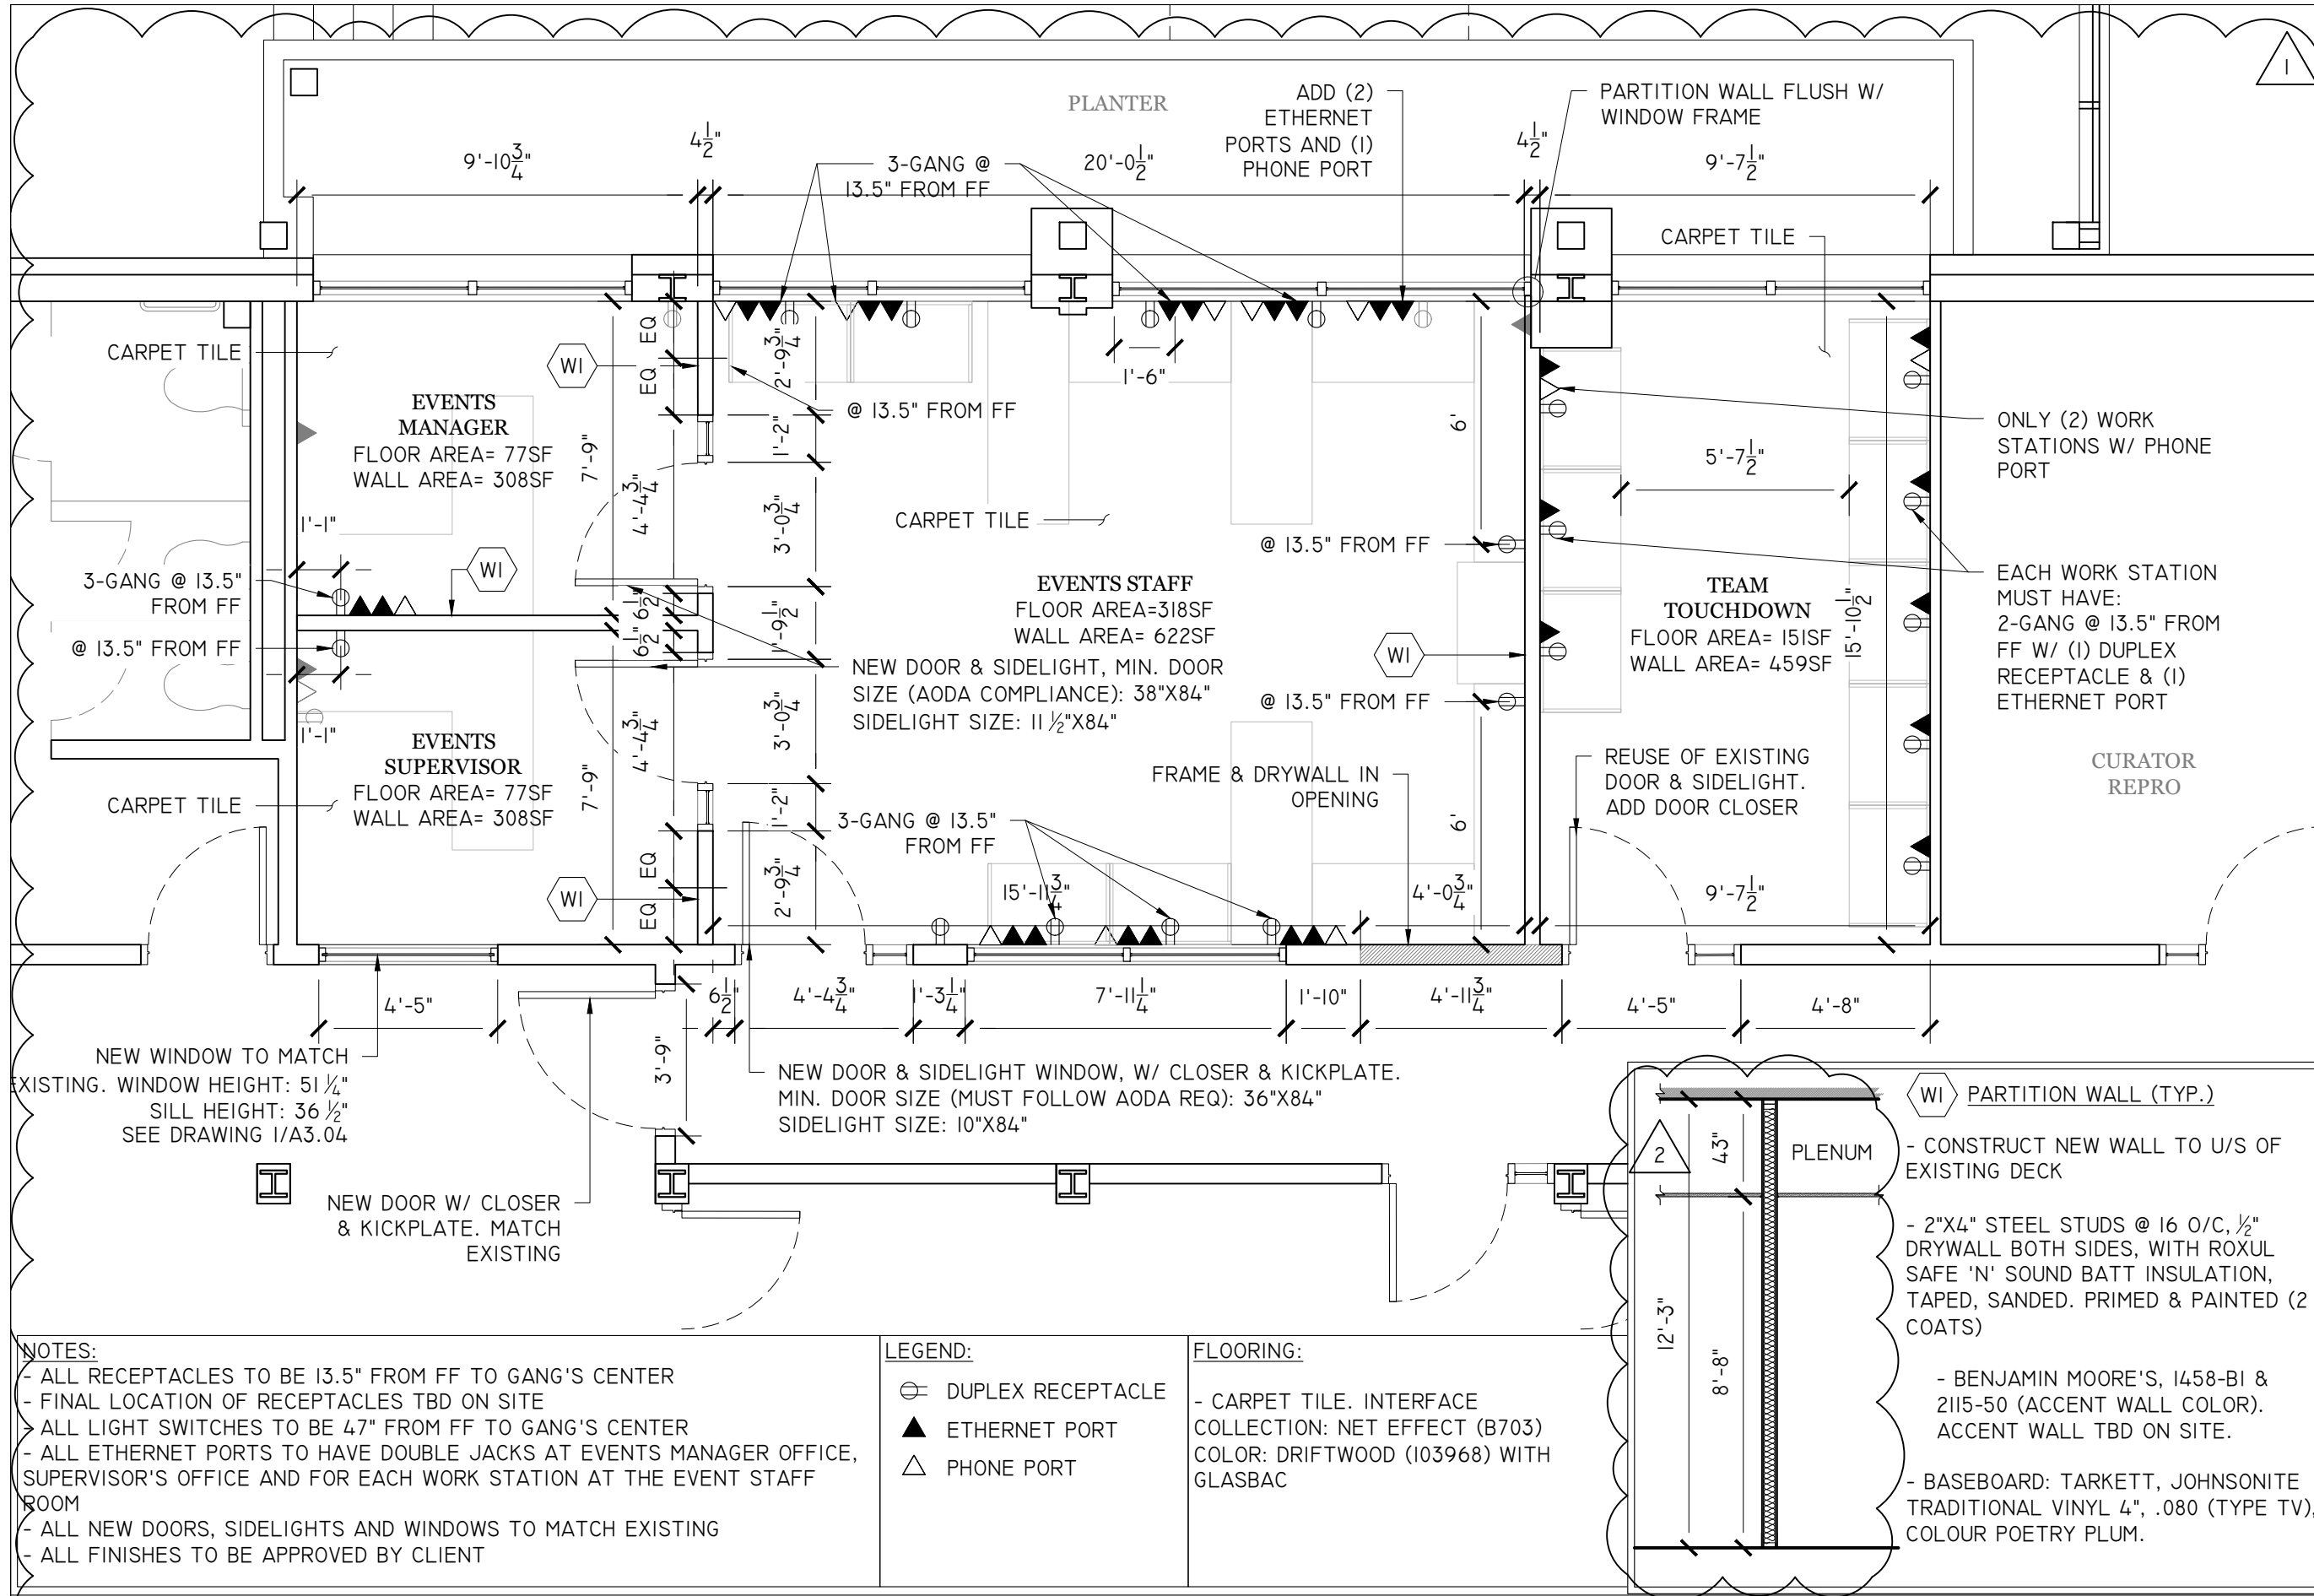

1 PROPOSED LAYOUT

SCALE: 1/4" = 1'-0"